



THIS DRAWING IS THE PROPERTY OF R A FORD LTD AND AS SUCH MAY NOT BE COPIED OR COMMUNICATED TO A THIRD PARTY WITHOUT WRITTEN AUTHORISATION. DO NOT SCALE FROM THIS DRAWING: IF IN DOUBT ASK


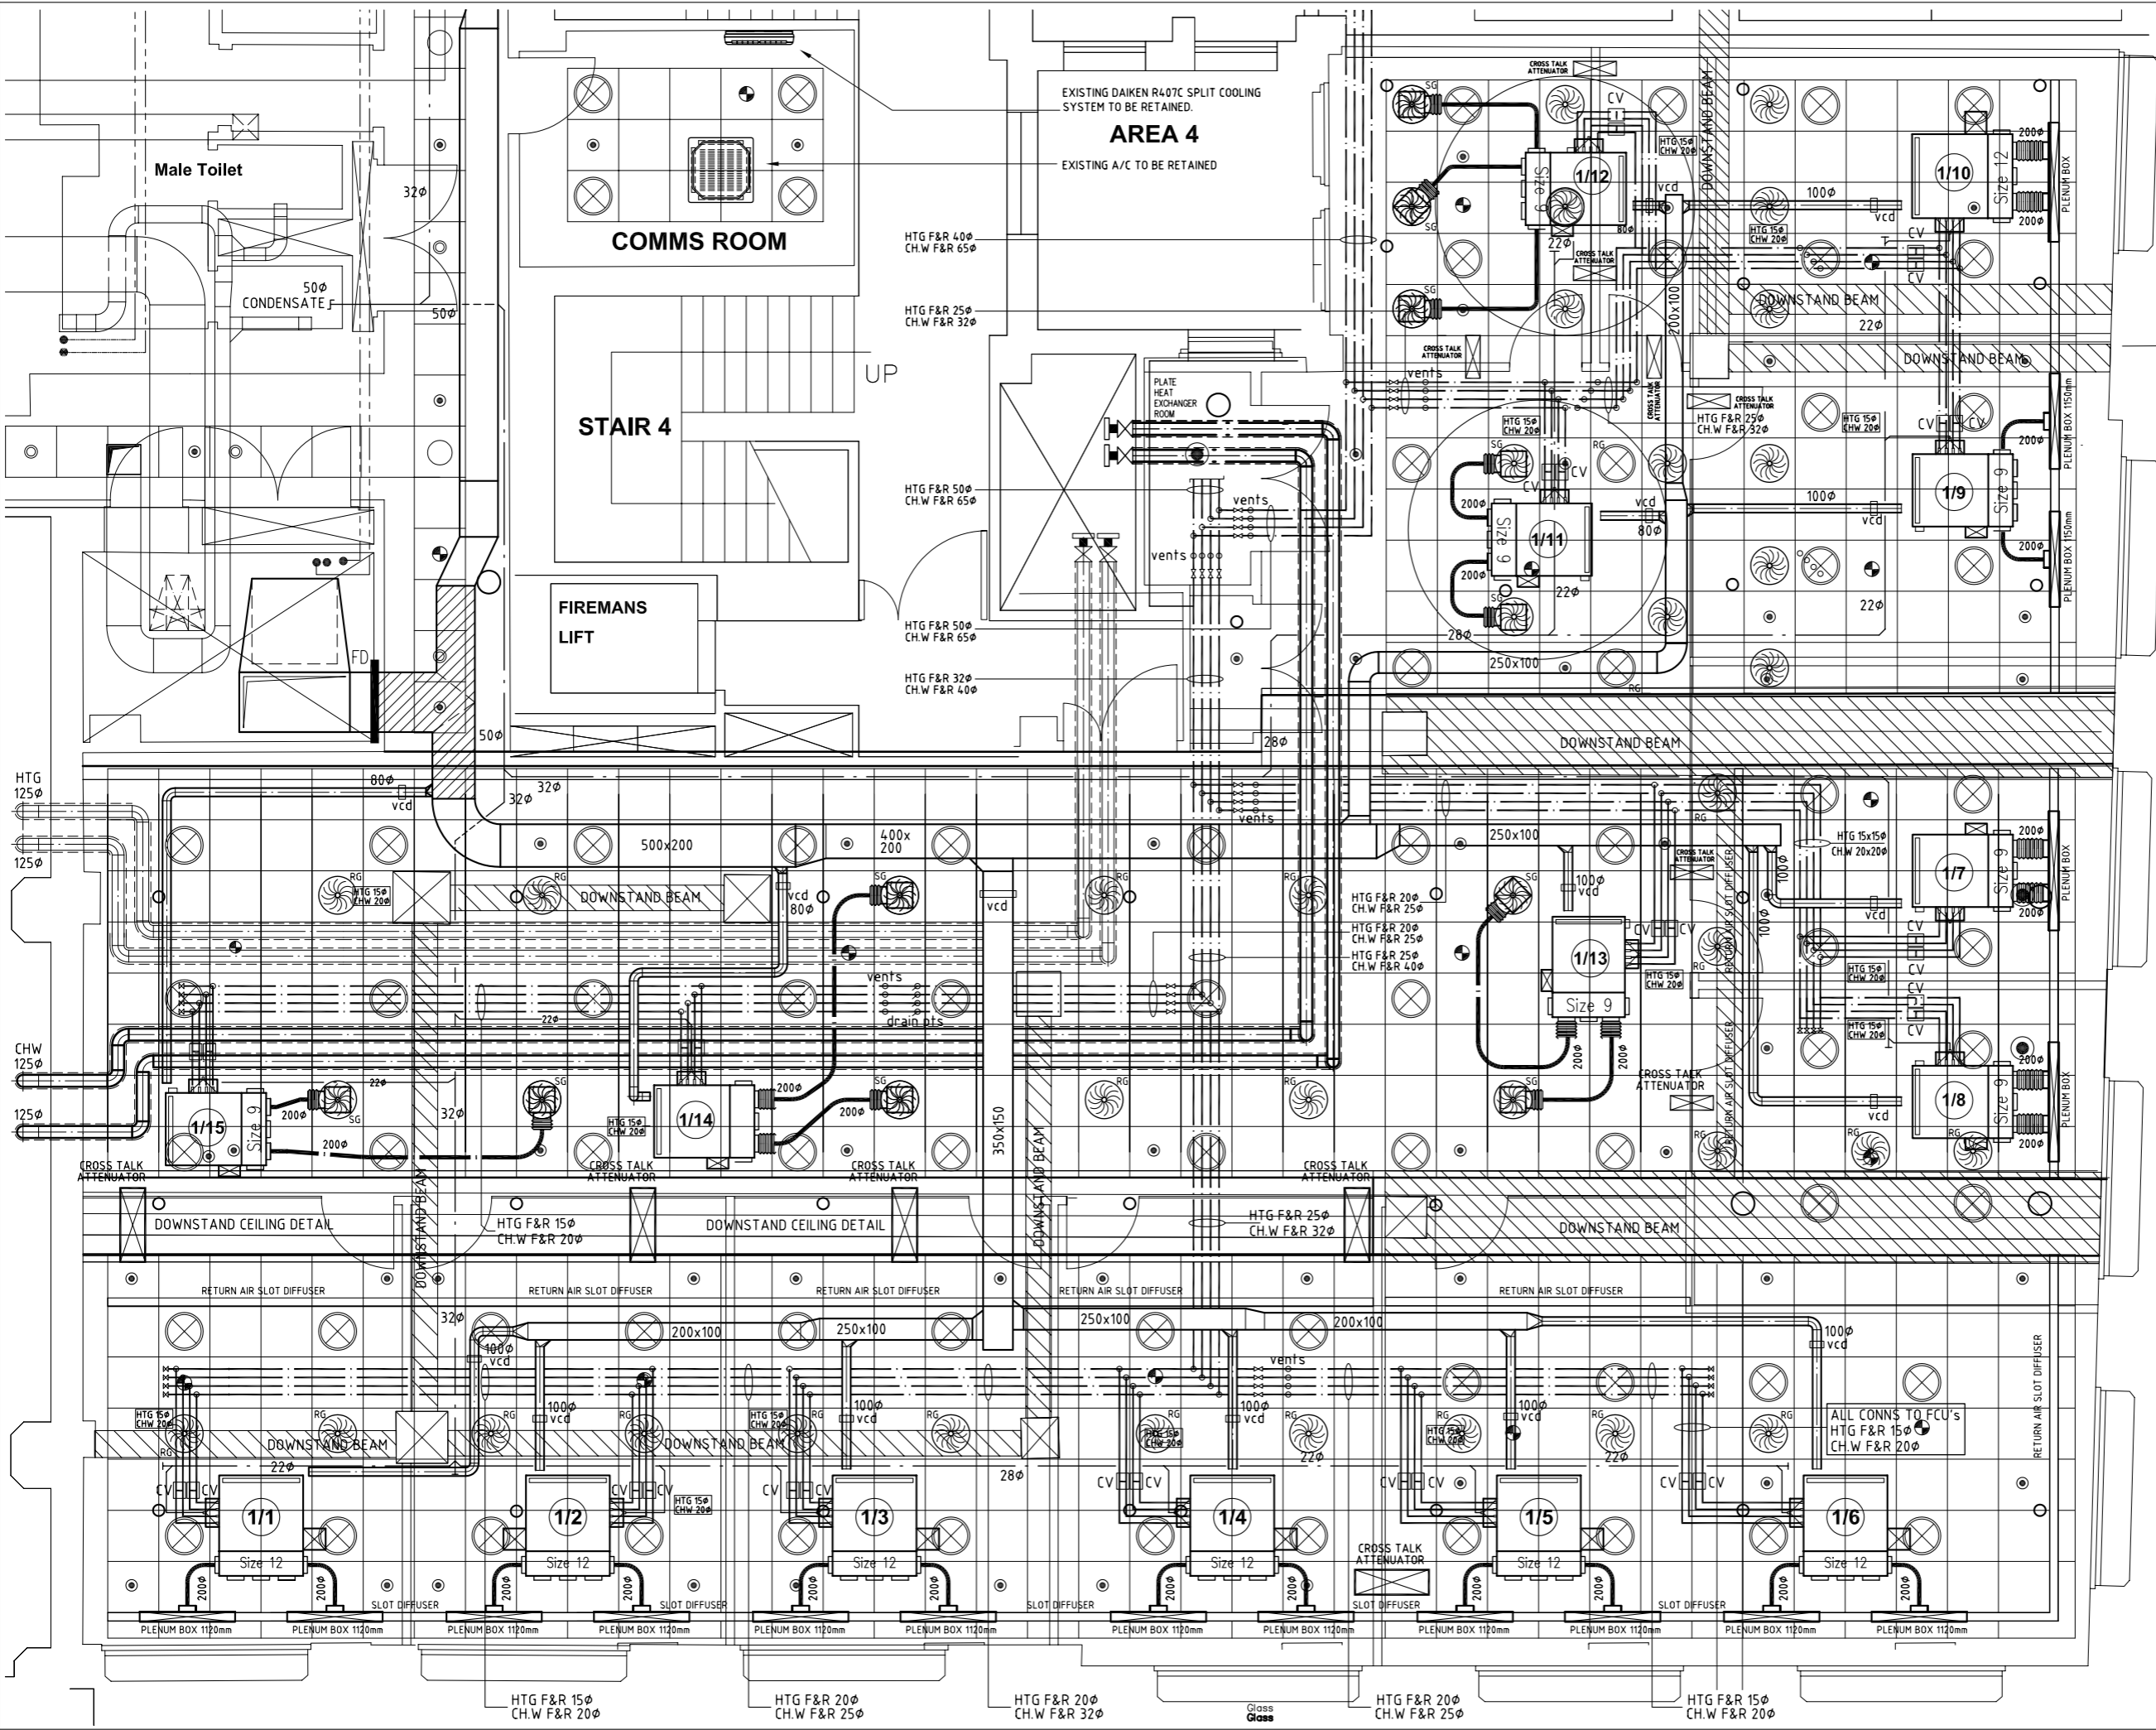


	recessed luminaire
	recessed wallwasher
	recessed downlight
	smoke/heat detector
	circular supply grill
	circular return grill
	sprinkler head ceiling
	sprinkler head void
	Ceiling cavity fire barrier

FAN COIL UNIT CONNECTION DETAIL - HTG/CHW

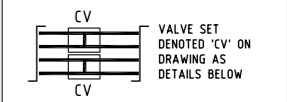

ALL FAN COILS TO HAVE IV ON FLOW, LOW FLOW COMMISSIONING STATION ON RETURN, AND IV ON PERMANENT BYPASS - ALL CONTAINED IN DOMINATOR Z3000 VALVE SET

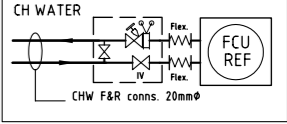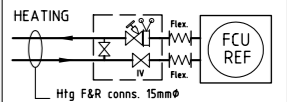

R	AS INSTALLED RECORD DRAWING	SEPT 06
Rev	Description	Date

client
LandSecurities

consultant
JOHN NOAD (Building Environment) Ltd

project
**DEVONSHIRE HOUSE
LONDON W1**

R.A. FORD Ltd
H.V.A.C BUILDING SERVICES ENGINEERS
Unit 6, Canons Road, Canon Industrial Estate, Old Worton
Milton Keynes, Bucks MK12 5TL
T: 01908 221007 F: 01908 221300 E: raford@btconnect.com

drawing title
**ENGINEERING SERVICES
FIRST FLOOR
FAN COIL INSTALLATION LAYOUT
SHEET 1 OF 2**

Scale	1:25 @ A0	Drawn	RF/MK
Date	SEPT 06	Checked	RF

drawing number	RA/M/03	revision	R
----------------	---------	----------	---

drawing status
RECORD DRAWING