


THIS DRAWING IS THE PROPERTY OF R.A. FORD Ltd
 AND AS SUCH MAY NOT BE COPIED OR COMMUNICATED TO
 A THIRD PARTY WITHOUT WRITTEN AUTHORISATION
 DO NOT SCALE FROM THIS DRAWING: IF IN DOUBT ASK


- recessed luminaire
- recessed wallwasher
- recessed downlight
- recessed downlight
- smoke /heat detector
- circular supply grill
- circular return grill
- sprinkler head ceiling
- sprinkler head void
- Ceiling cavity fire barrier

FAN COIL UNIT CONNECTION DETAIL - HTG/CHW

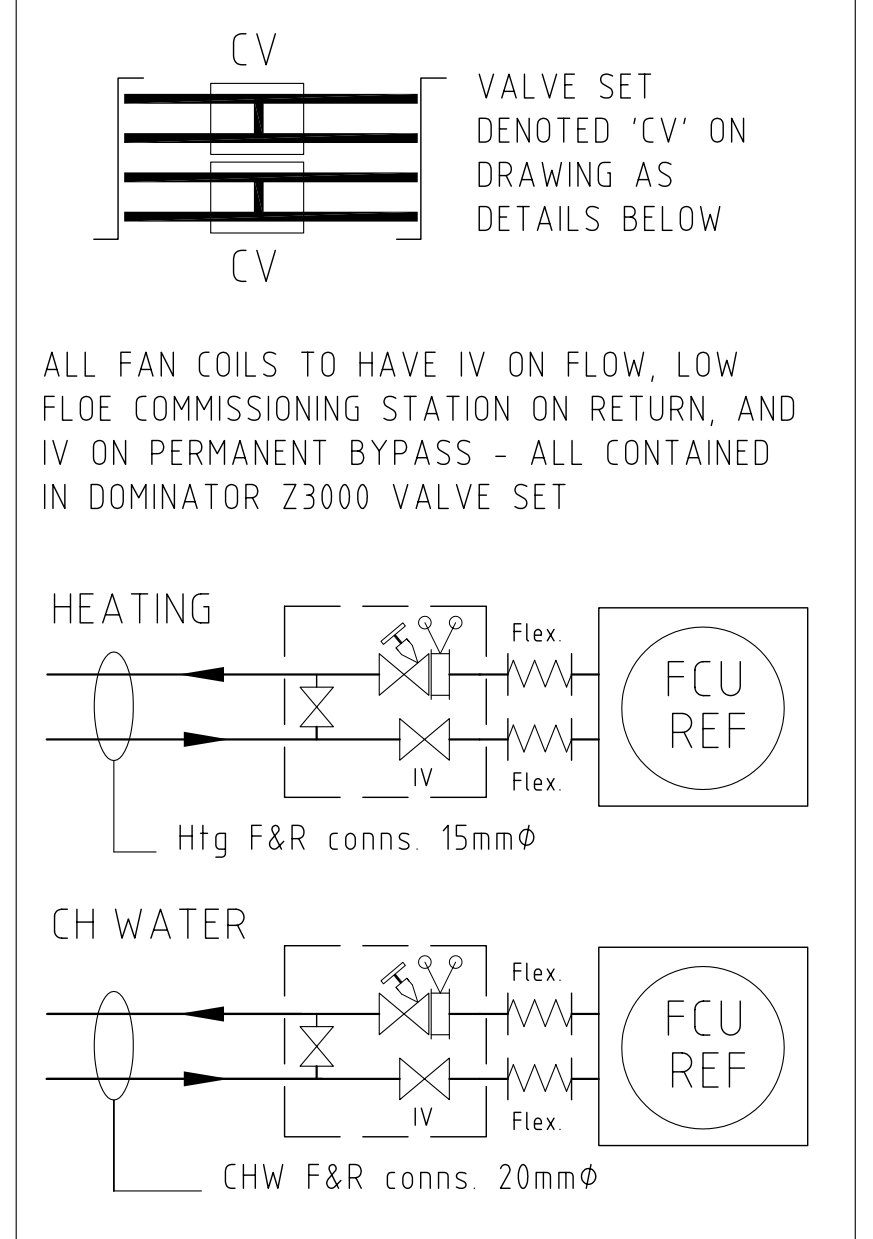

OFFICES

AREA 5 AIR INTAKE

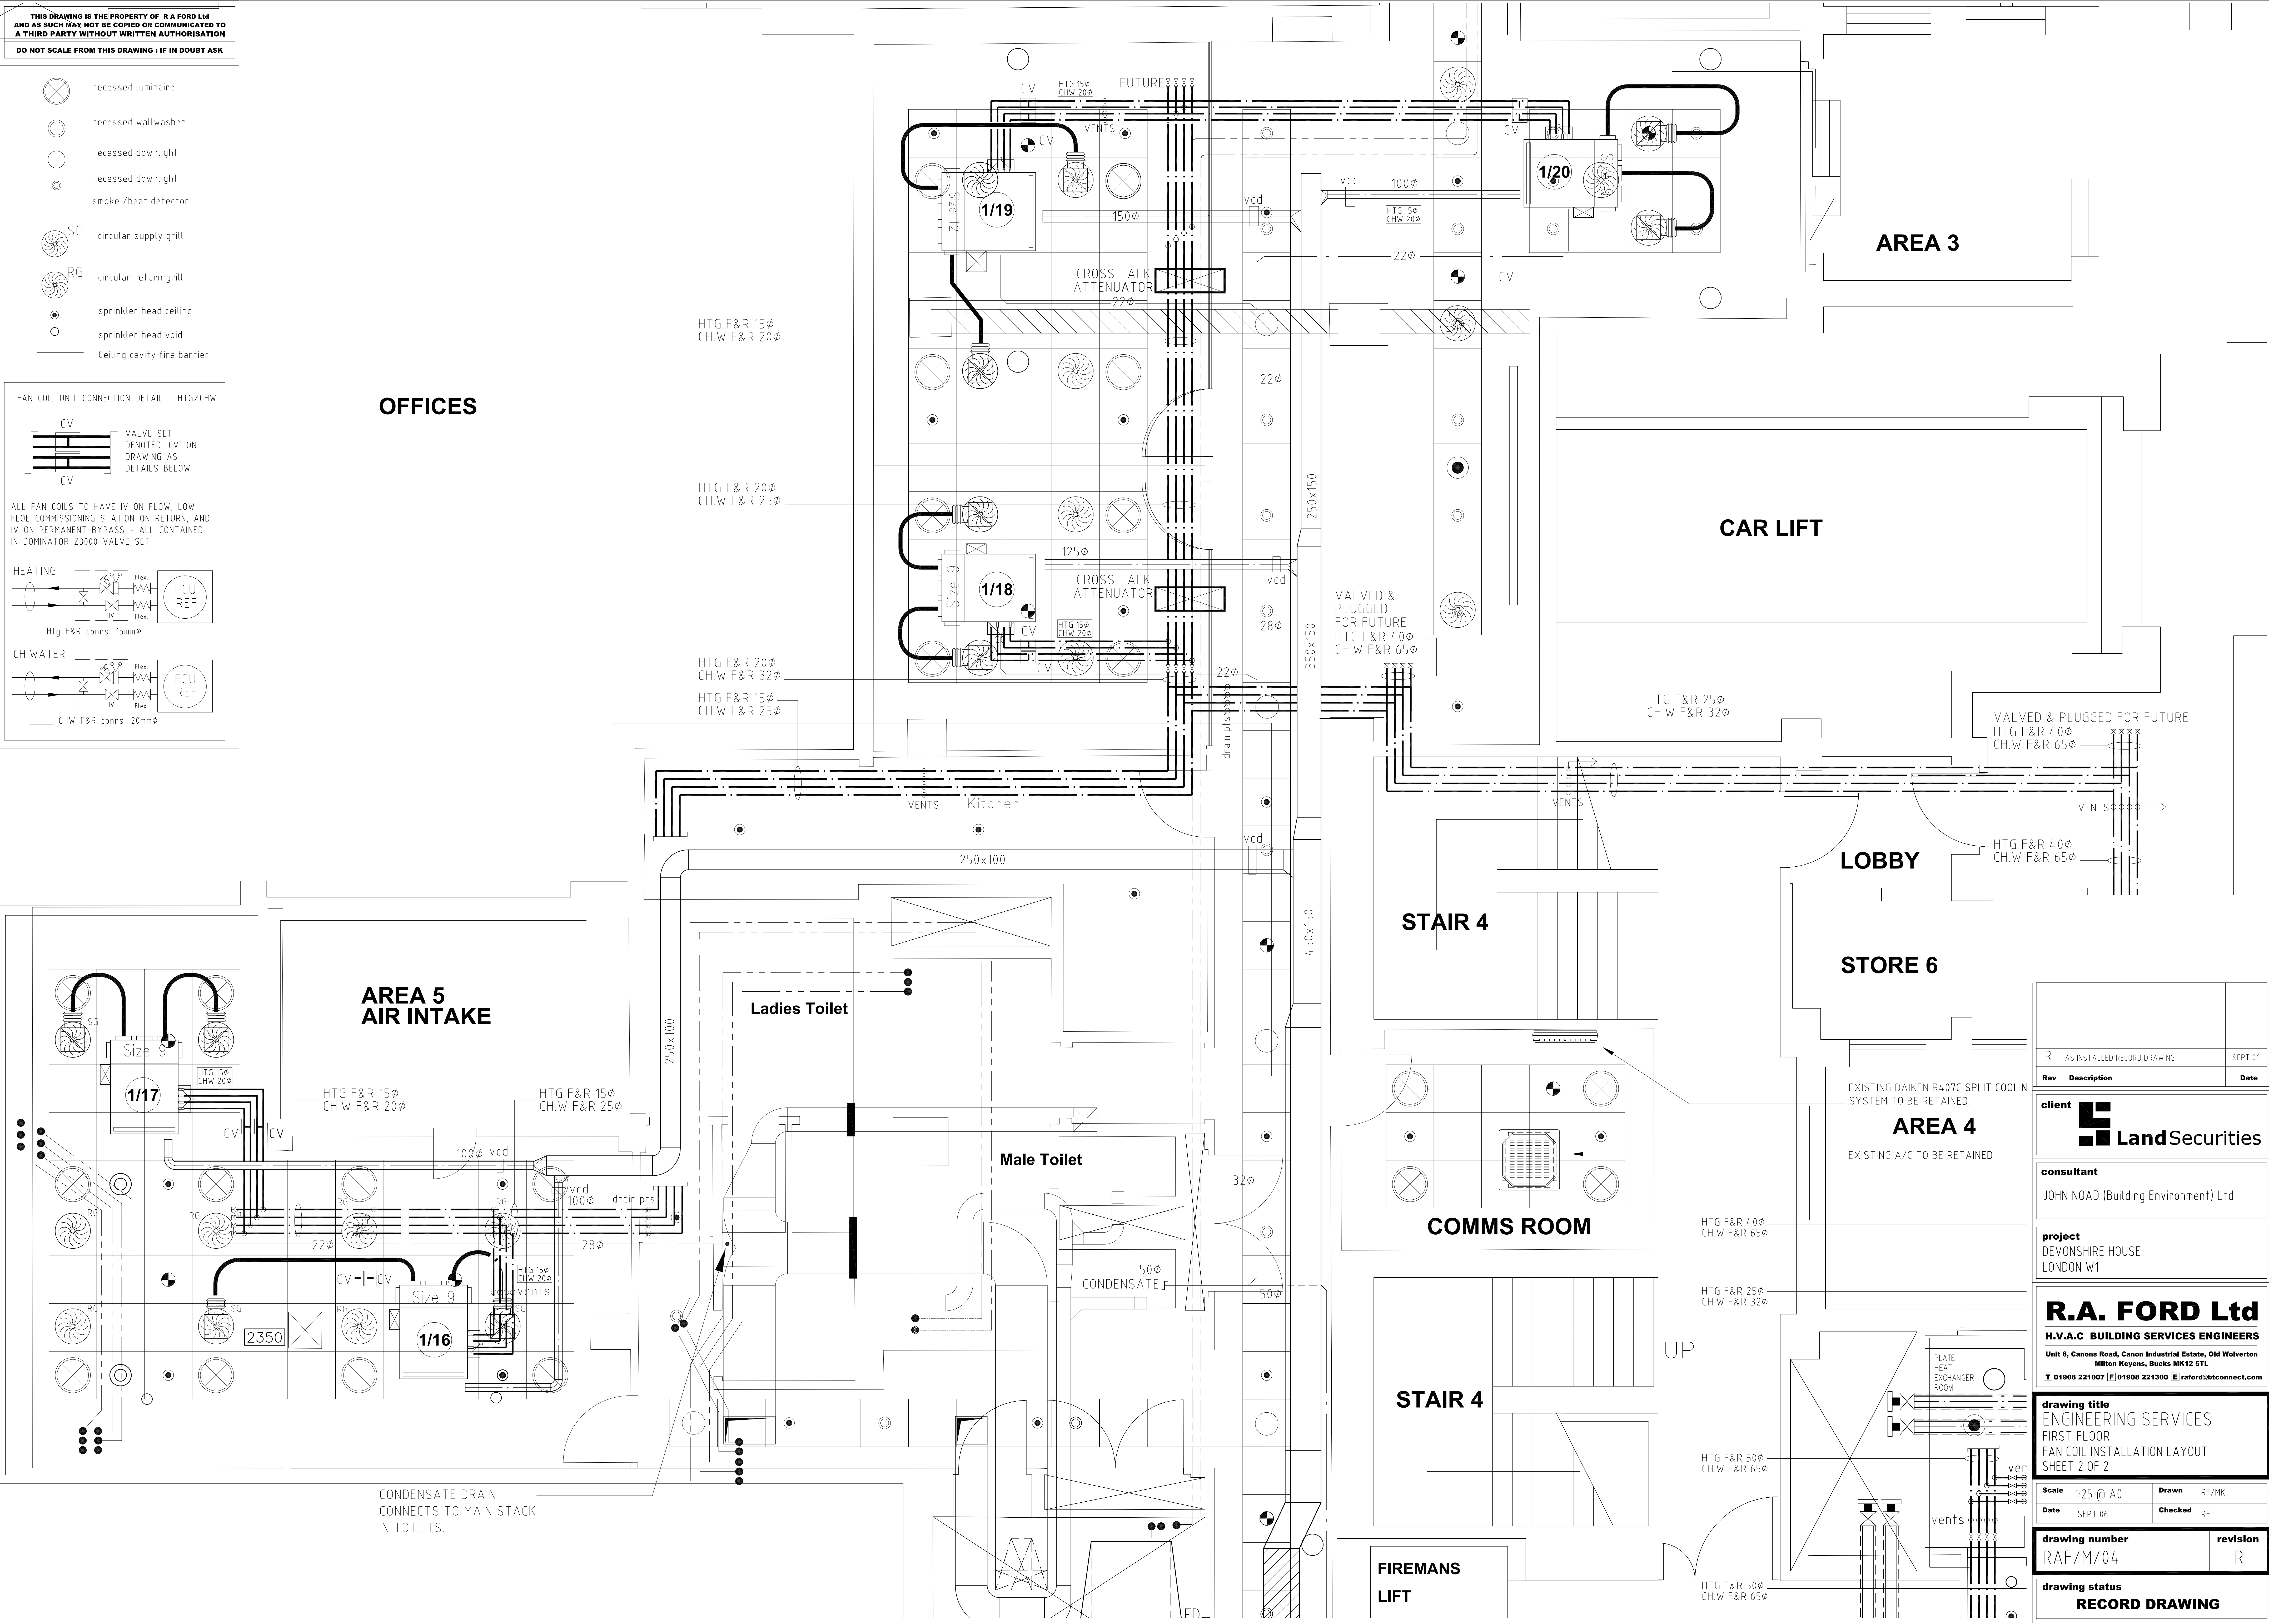

CONDENSATE DRAIN
 CONNECTS TO MAIN STACK
 IN TOILETS.

R	AS INSTALLED RECORD DRAWING	SEPT 06
Rev	Description	Date
client		
LandSecurities		
consultant		
JOHN NOAD (Building Environment) Ltd		
project		
DEVONSHIRE HOUSE LONDON W1		
R.A. FORD Ltd		
H.V.A.C BUILDING SERVICES ENGINEERS		
Unit 6, Canons Road, Canon Industrial Estate, Old Wolverton Milton Keynes, Bucks MK12 5TL		
T: 01908 221007 F: 01908 221300 E: raford@btconnect.com		
drawing title		
ENGINEERING SERVICES FIRST FLOOR FAN COIL INSTALLATION LAYOUT SHEET 2 OF 2		
Scale	1:25 @ A0	Drawn RF/MK
Date	SEPT 06	Checked RF
drawing number		revision
RAF/M/04		R
drawing status		
RECORD DRAWING		